⊌ate:

Tuesday, 16/12/2008 2:12:24 PM

User:

Julie Dawson

## **Process Sheet**

**Drawing Name** 

**Part Number** 

**Drawing Number** 

**Project Number** 

**Drawing Revision** 

Customer

: CU-DAR001 Dart Helicopters Services

Type

S.O. No. :

Job Number

: 44122A02

**Estimate Number** 

: 10147

P.O. Number

Prsht Rev.

This Issue

: 16/12/2008 : NC

: // First Issue

: 41316A02

Previous Run Written By

Checked & Approved By Comment

: Est Rev:A

New Issue

05-11-01 JLM

: SMALL /MED FAB

Material **Due Date** 

: 22/12/2008

: D20132

: N/A

: C

. D2013 REV C

: MIRROR BRACKET RH

Qty:

4 Um:

Each

Additional Product

Job Number:



Seq. #:

Machine Or Operation:

**Description:** 304 RD Tube .750 x .049W

M304TR0750W049 1.0

Comment: Qty.: Total: 8.1787 f(s) 2.0447 f(s)/Unit

Material: 3/4 O.D. x .049" wall, 304/316 SS Seamless Tubing

(M304TR0.750W.049) Batch: MIIOII3

BRAKE NC 2.0

NC BRAKE



Comment: NC BRAKE

1-Punch as per template D2013-T1and Dwg D2013

2-Flatten ends of D2013-2 tube as per Dwg D2013 using DT8545

3-Bend (1) tube as per Dwg D2013 using Jig DT8201Identify as D2013-2.

4-Deburr as required

3.0 QC5 INSPECT WORK TO CURRENT STEP



Comment: INSPECT WORK TO CURRENT STEP

4.0

QC21

FINAL INSPECTION/W/O RELEASE



Comment: FINAL INSPECTION/W/O RELEASE

Job Completion



(las

Page 1


## **Dart Aerospace Ltd**

Dail Ac	vapace	Liu									
W/O:			WC	ORK ORDER CHANG	ES	<del></del>					
DATE	STEP	PROCEDURE CHANGE			1	Зу	Date	Qty	Approval Chief Eng / Prod Mgr	Approval QC Inspector	
			<del>, , , , , , , , , , , , , , , , , , , </del>								
Part No	:	PAR #:	Fault Category: NC			CR: Yes No DQA: Date:					
	Re	esolution:				A: N/C Closed: Date:					
NCR:		\	WORK ORD	ER NON-CONFORMA	ANCE (	NCR)					
DATE	STEP	Description of NC Section A	Corrective Action Section				Verification		Approval	Approval	
			Initial Chief Eng	Action Description Chief Eng		Sign & Date	Section C		Chief Eng	QC Inspector	
							1				
•											
										Ì	

NOTE: Date & initial all entries



ſ	DESIG	N	DRAWN BY	DART AEROSPACE LTD
ı		JB.	RF	HAWKESBURY, ONTARIO, CANADA
	CHECK	(ED	APPROVED	DRAWING NO. REV. C
١		KE	100	D2013 SHEET 1 OF 3
١	DATE		· 7	TITLE SCALE
	99.0	06.07		MIRROR BRACKET NTS
	Α		90.10.22	NEW ISSUE
	В		94.06.15	REDRAWN
	O		99.06.07	REDRAWN, CHANGE OF DIMENSIONS

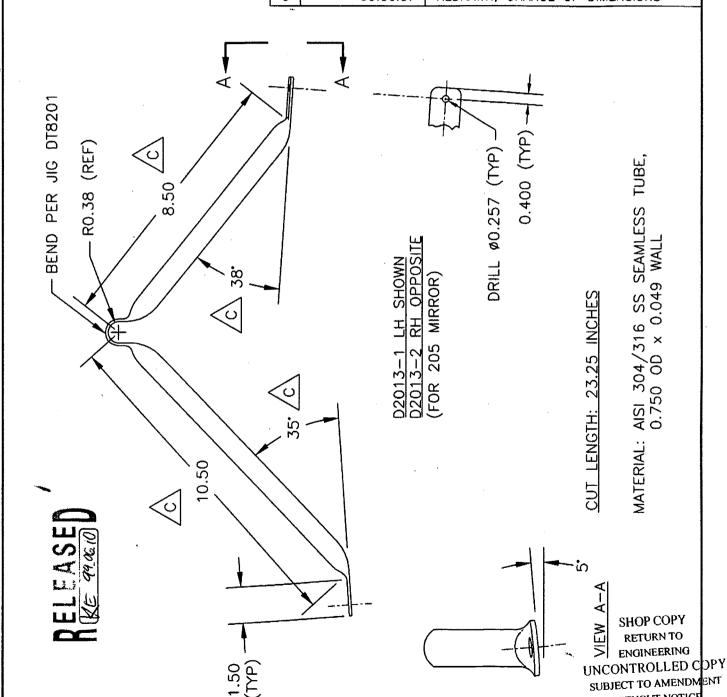

Copyright 1990 by DART AEROSPACE LTD

DESIGN JB	DRAWN BY		SPACE LTD INTARIO, CANADA
CHECKED	APPROVED	DRAWING NO.	REV. C
KE	14	D2013	SHEET 2 OF 3
DATE		TITLE	SCALE
		1	



